


REFERENCE DRAWINGS			
DISCIPLINE	DRAWING NUMBER	REV	DATE
STRUCT			
MECH			
ELEC			
SCF			
ARCH			

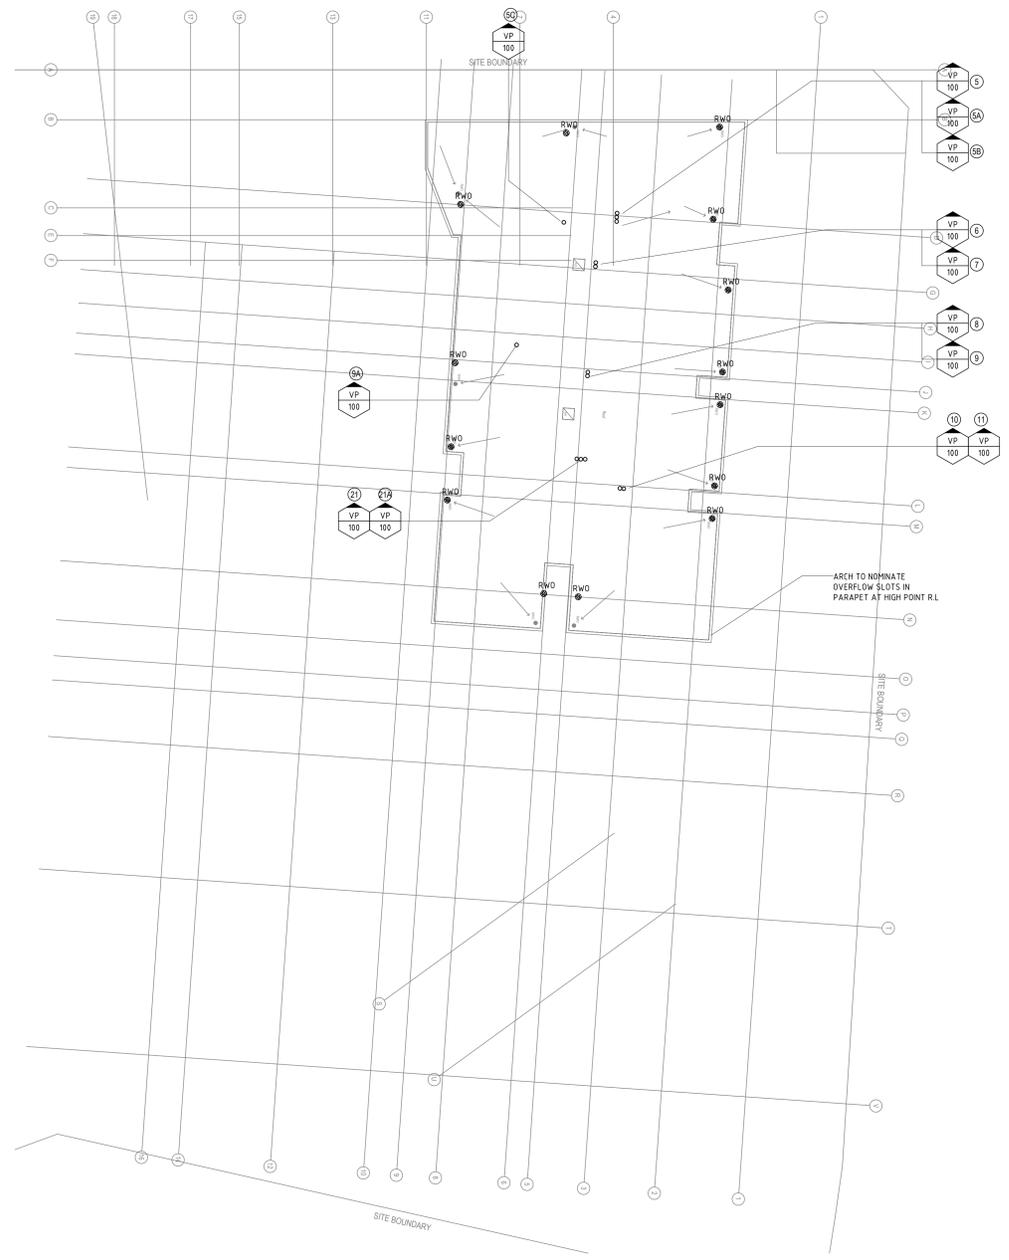

AS BUILT

NOTES

1. COPYRIGHT OF ALIGN ENGINEERING GROUP. All rights reserved. This drawing may not be reproduced or transmitted in any form, or by any means in part or in whole without permission from ALIGN ENGINEERING GROUP. Figure dimensions shall be taken in preference to scaling. The contractor shall check all dimensions on drawings and site before commencing work.

REVISION	DATE	ARCHITECT / PROJECT MANAGER
AB	AS BUILT	20/01/19
ISSUE	AMENDMENT	DATE

CLIENT

HOLDMARK

HYDRAULIC & FIRE SERVICES CONSULTANTS

ALIGN ENGINEERING GROUP

PO BOX 8013
PORT MACQUARIE
NSW 2444
T: 0403 852 312

Email: alan.thomas.aeg@gmail.com ABN2878949310

HYDRAULIC CONTRACTOR

KWIK FLO
group.com.au

PROJECT

**KINGSTON QUATER
20 NANCARROW AVE
MEADOWBANK NSW 2114**

PROJECT No.	DATE	DRAWN	No IN SET	SCALE
AEG105	20/01/19	AT		1 TO 200 @ B1

DRAWING TITLE		REVISION
HYDRAULIC SERVICES LEVEL 12 GRAVITY SERVICES		
AEG-H18	AB	