


SERVICES ON THIS DRAWING ARE SHOWN IN THE STRATA (UNLESS NOTED OTHERWISE)

REFERENCE DRAWINGS			
STRUCT			
MECH			
ELEC			
RFID			
ARCH			
DISCIPLINE	DRAWING NUMBER	REV	DATE

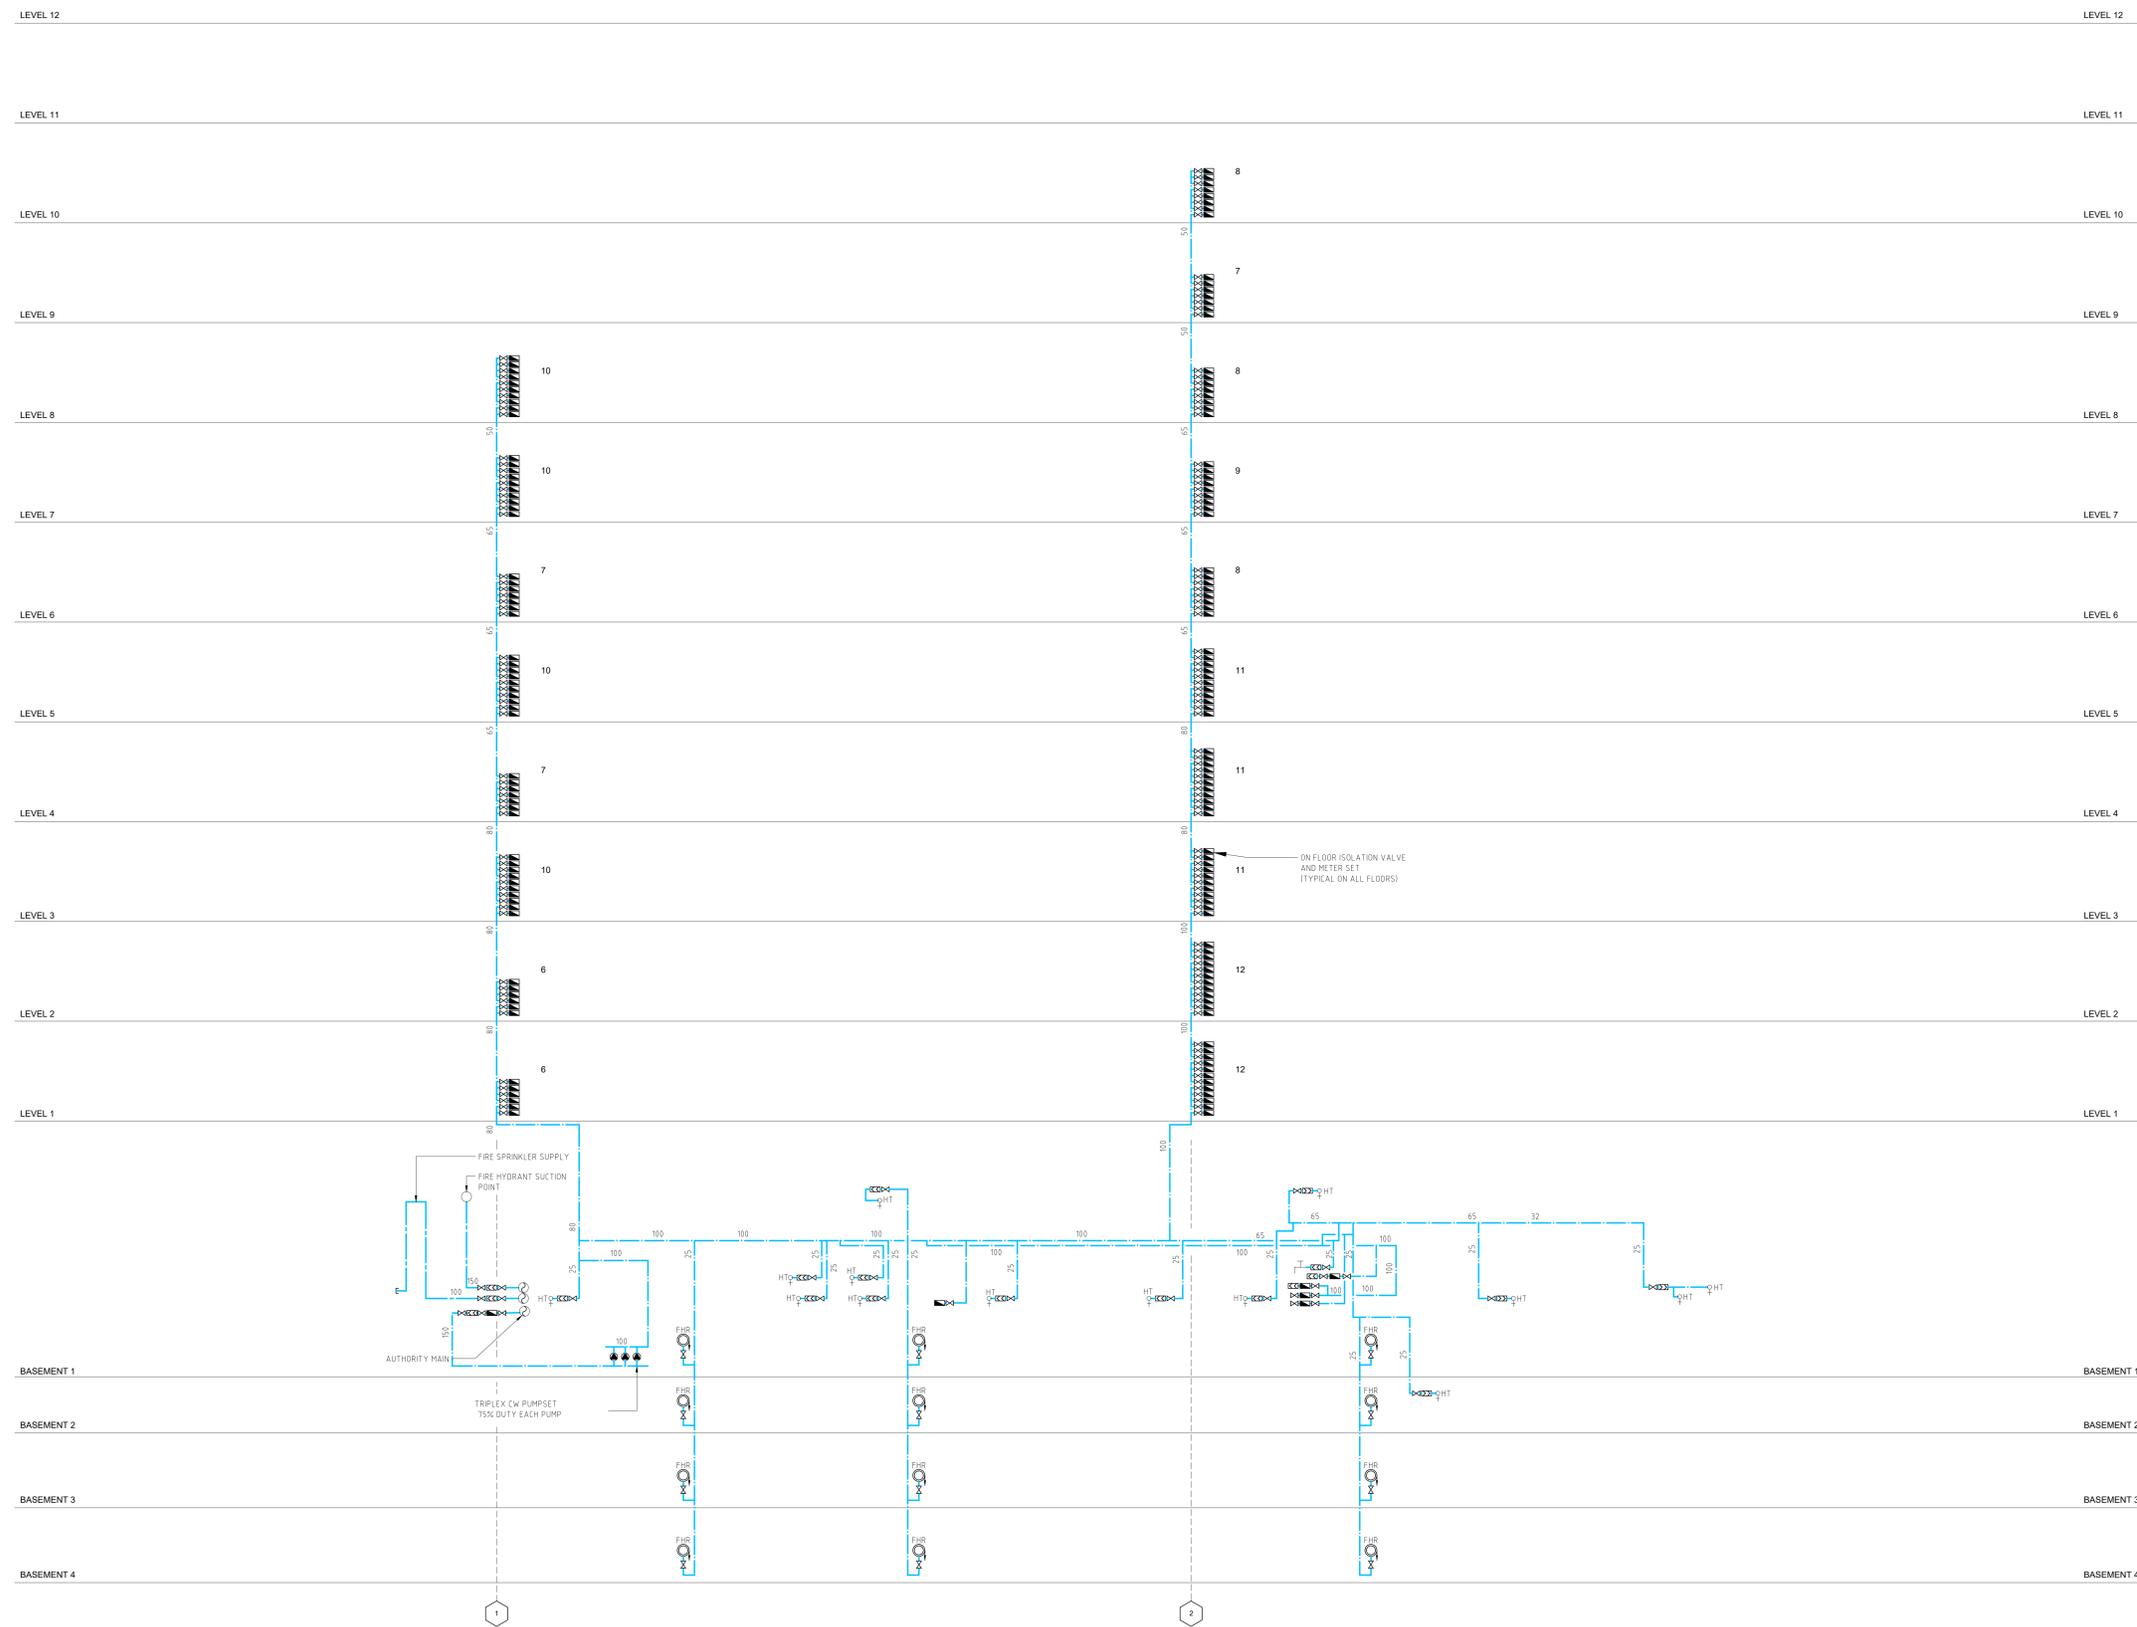

AS BUILT

NOTES

COPYRIGHT OF ALION ENGINEERING GROUP. All rights reserved. This drawing may not be reproduced or transmitted in any form, or by any means in part or in whole without permission from ALION ENGINEERING GROUP. Figure dimensions shall be taken in preference to scaling. The contractor shall check all dimensions on drawings and site before commencing work.

REVISION	DATE	ISSUE	AMENDMENT	DATE
AS BUILT	20/01/19			

ARCHITECT / PROJECT MANAGER

CLIENT

**HOLDMARK**

2, 2-4 Giffnock Ave Macquarie Park NSW 2113  
 T 02 9889 5540  
 info@holdmark.com.au

HYDRAULIC & FIRE SERVICES CONSULTANTS

**ALION ENGINEERING GROUP**

PO BOX 8013  
 PORT MACQUARIE NSW 2444  
 T: 0403 852 312

Email: alan.thomas.aeg@gmail.com ABN2878949310

LOCATION PLAN

**KWIK FLO**  
 group.com.au

TRUE NORTH

PROJECT

**SHEPHERDS BAY 8**  
 20 - 36 NANCARROW AVE  
 MEADOWBANK N.S.W 2144

PROJECT No.	DATE	DRAWN	No IN SET	SCALE
AEG105	25/05/2012	AT		NTS @ A0

DRAWING TITLE

**HYDRAULIC SERVICES COLD WATER SCHEMATIC**

DRAWING No.	REVISION
<b>AEG-H37</b>	<b>AB</b>