


REFERENCE DRAWINGS			
STRUCT			
MECH			
ELEC			
ROF			
ARCH			
DISCIPLINE	DRAWING NUMBER	REV	DATE

PRESSURE LIMITING ZONE

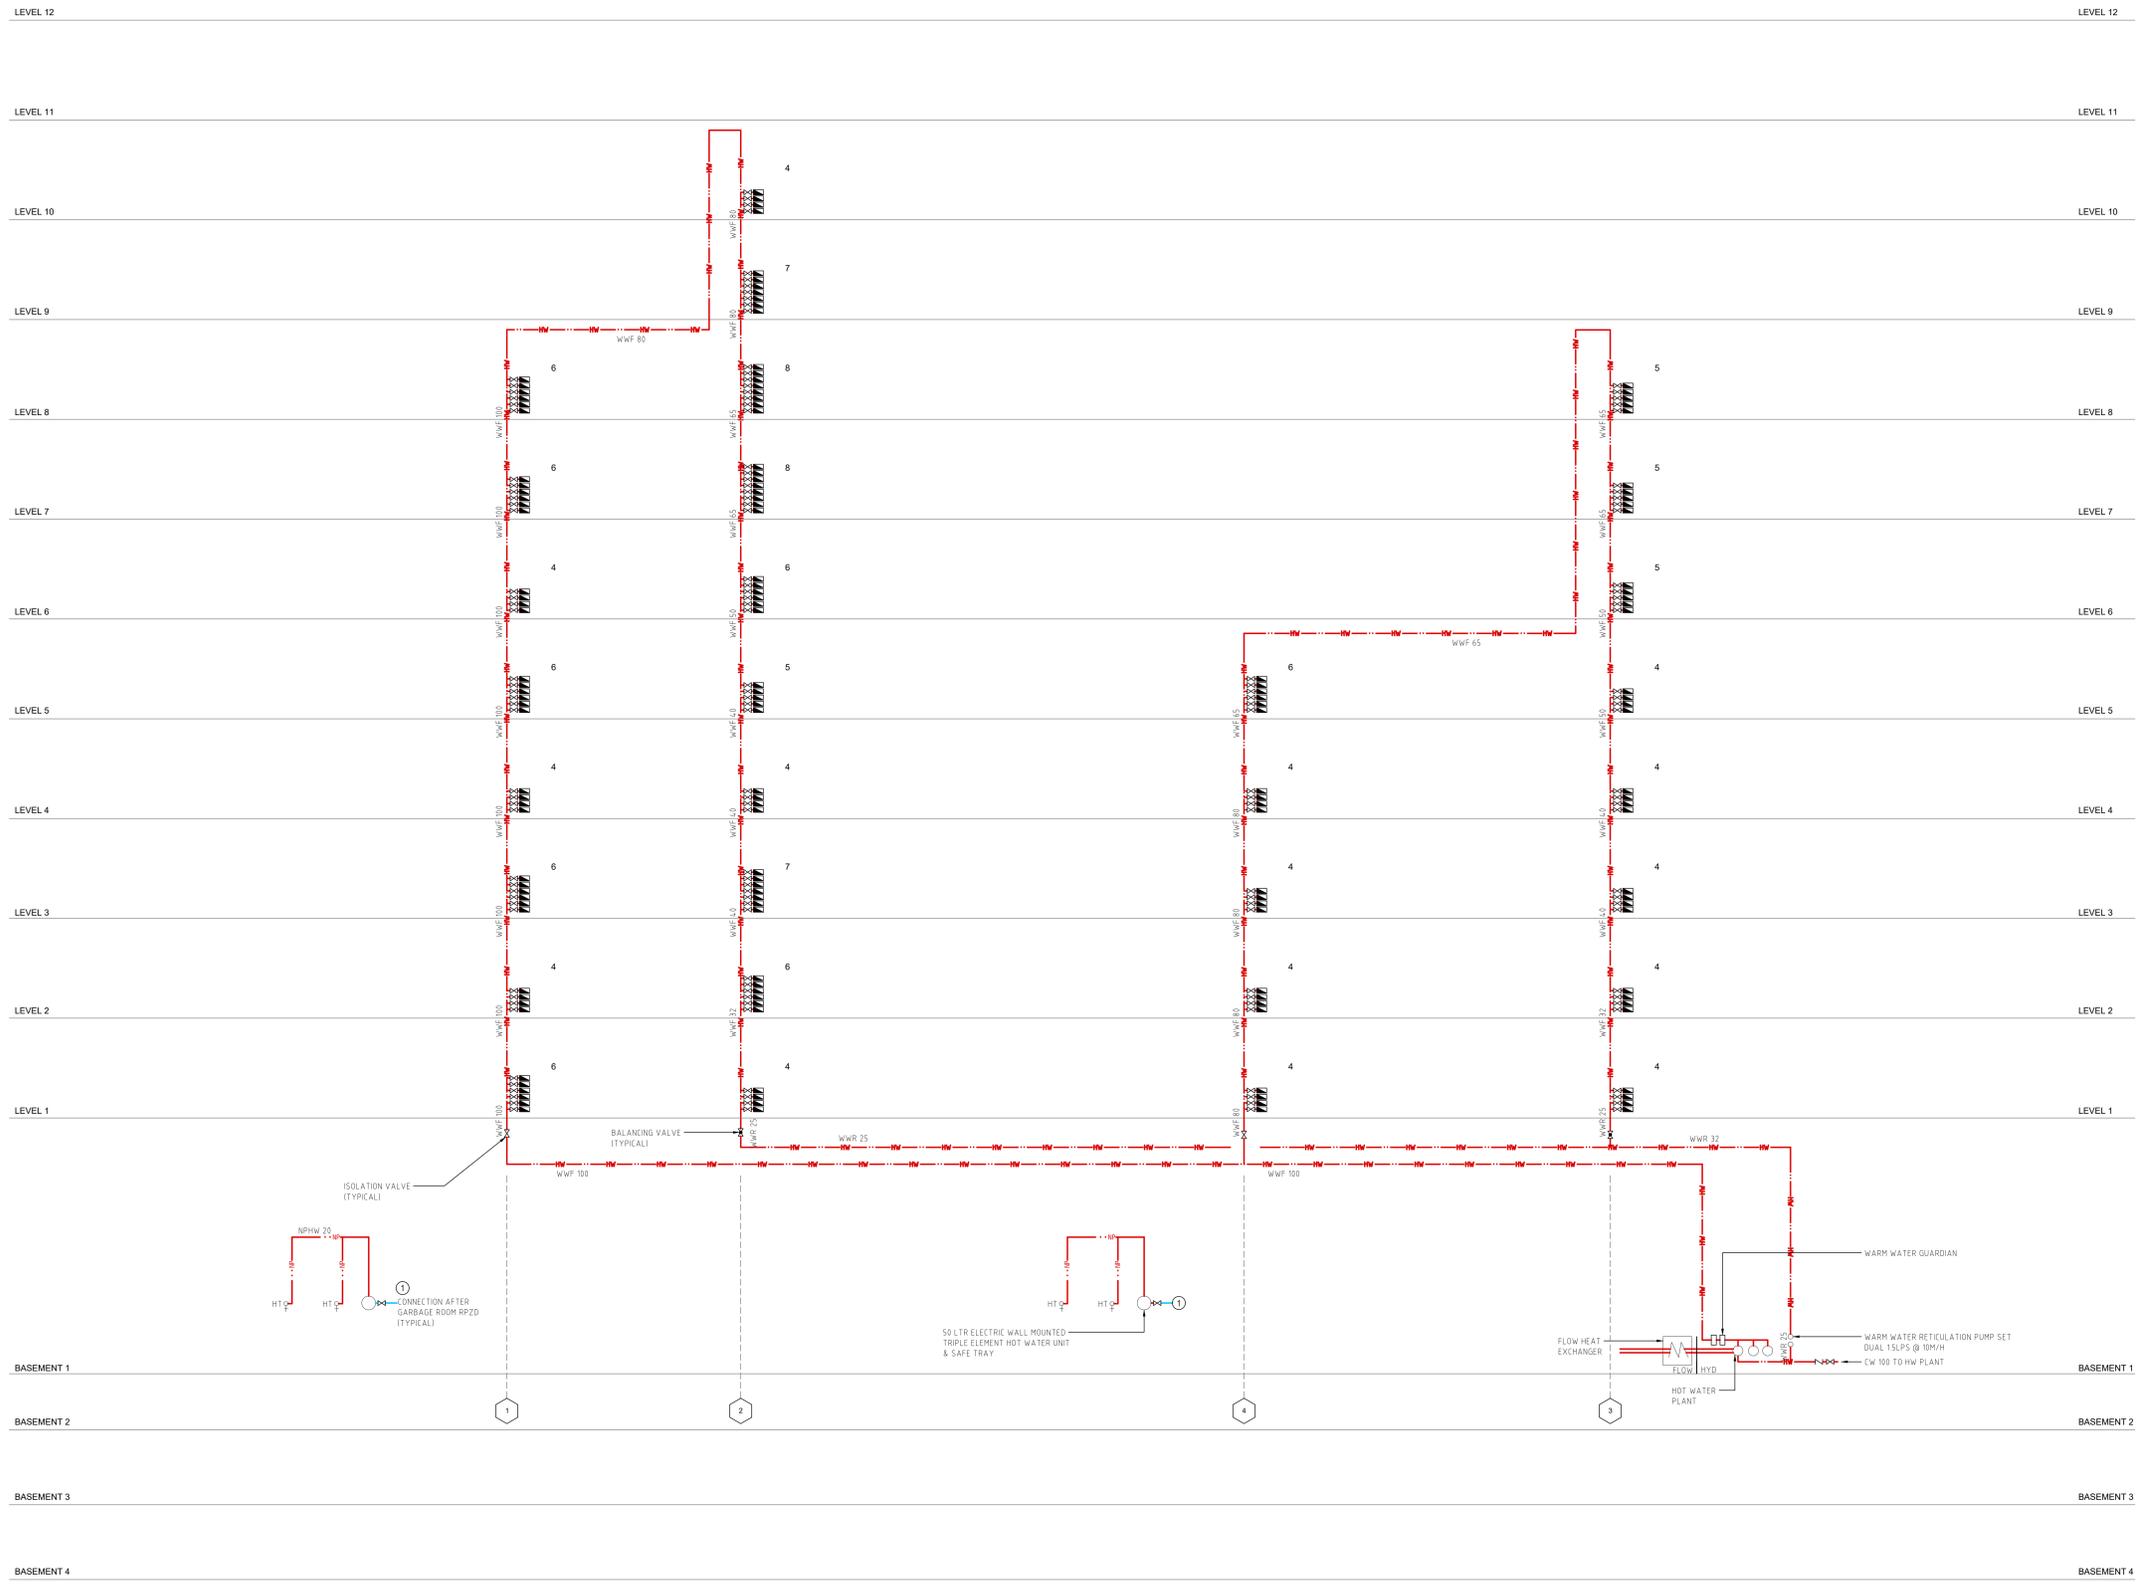

NOTE:  
THESE DRAWINGS ARE DIAGMATICAL ONLY  
AND DO NOT REPRESENT TRUE QUANTITIES OF  
PARTS AND MATERIALS

AS BUILT

NOTES		
COPYRIGHT OF ALION ENGINEERING GROUP. All rights reserved. This drawing may not be reproduced or transmitted in any form, or by any means in part or in whole without permission from ALION ENGINEERING GROUP. Figure dimensions shall be taken in preference to scaling. The contractor shall check all dimensions on drawings and site before commencing work.		
AS BUILT	AS BUILT	20/01/19
ISSUE	AMENDMENT	DATE

ARCHITECT / PROJECT MANAGER	

CLIENT

2, 2-4 Giffnock Ave Macquarie Park  
NSW 2113  
T 02 9889 5540  
info@holdmark.com.au

HYDRAULIC & FIRE SERVICES CONSULTANTS

PO BOX 8013  
PORT MACQUARIE  
NSW 2444  
T: 0403 852 312  
Email: alan.thomas.aeg@gmail.com ABN2878949310

LOCATION PLAN

TRUE NORTH

PROJECT

**SHEPHERDS BAY**  
**8**  
**20 - 36 NANCARROW AVE**  
**MEADOWBANK N.S.W 2144**

PROJECT No.	DATE	DRAWN	SCALE
AEG105	25/05/2012	AT	NTS @ A0

DRAWING TITLE

**HYDRAULIC SERVICES**  
**WARM WATER**  
**SCHEMATIC**

DRAWING No.	REVISION
<b>AEG-H38</b>	<b>AB</b>