


SERVICES ON THIS DRAWING ARE SHOWN IN THE STRATA UNLESS NOTED OTHERWISE.

REFERENCE DRAWINGS			
STRUCT			
MECH			
ELEC			
ROF			
ARCH			
DISCIPLINE	DRAWING NUMBER	REV	DATE

INDEX LENGTH	100MTRS
PRESSURE DROP	0.75KPA
PRESSURE	2.75KPA
SIZE	LOAD
20	67
25	147
32	281
40	474
50	1090
65	2018
80	3209
100	7093

1 X HOT PLATE @ 45MJ/H PER APARTMENT ONLY

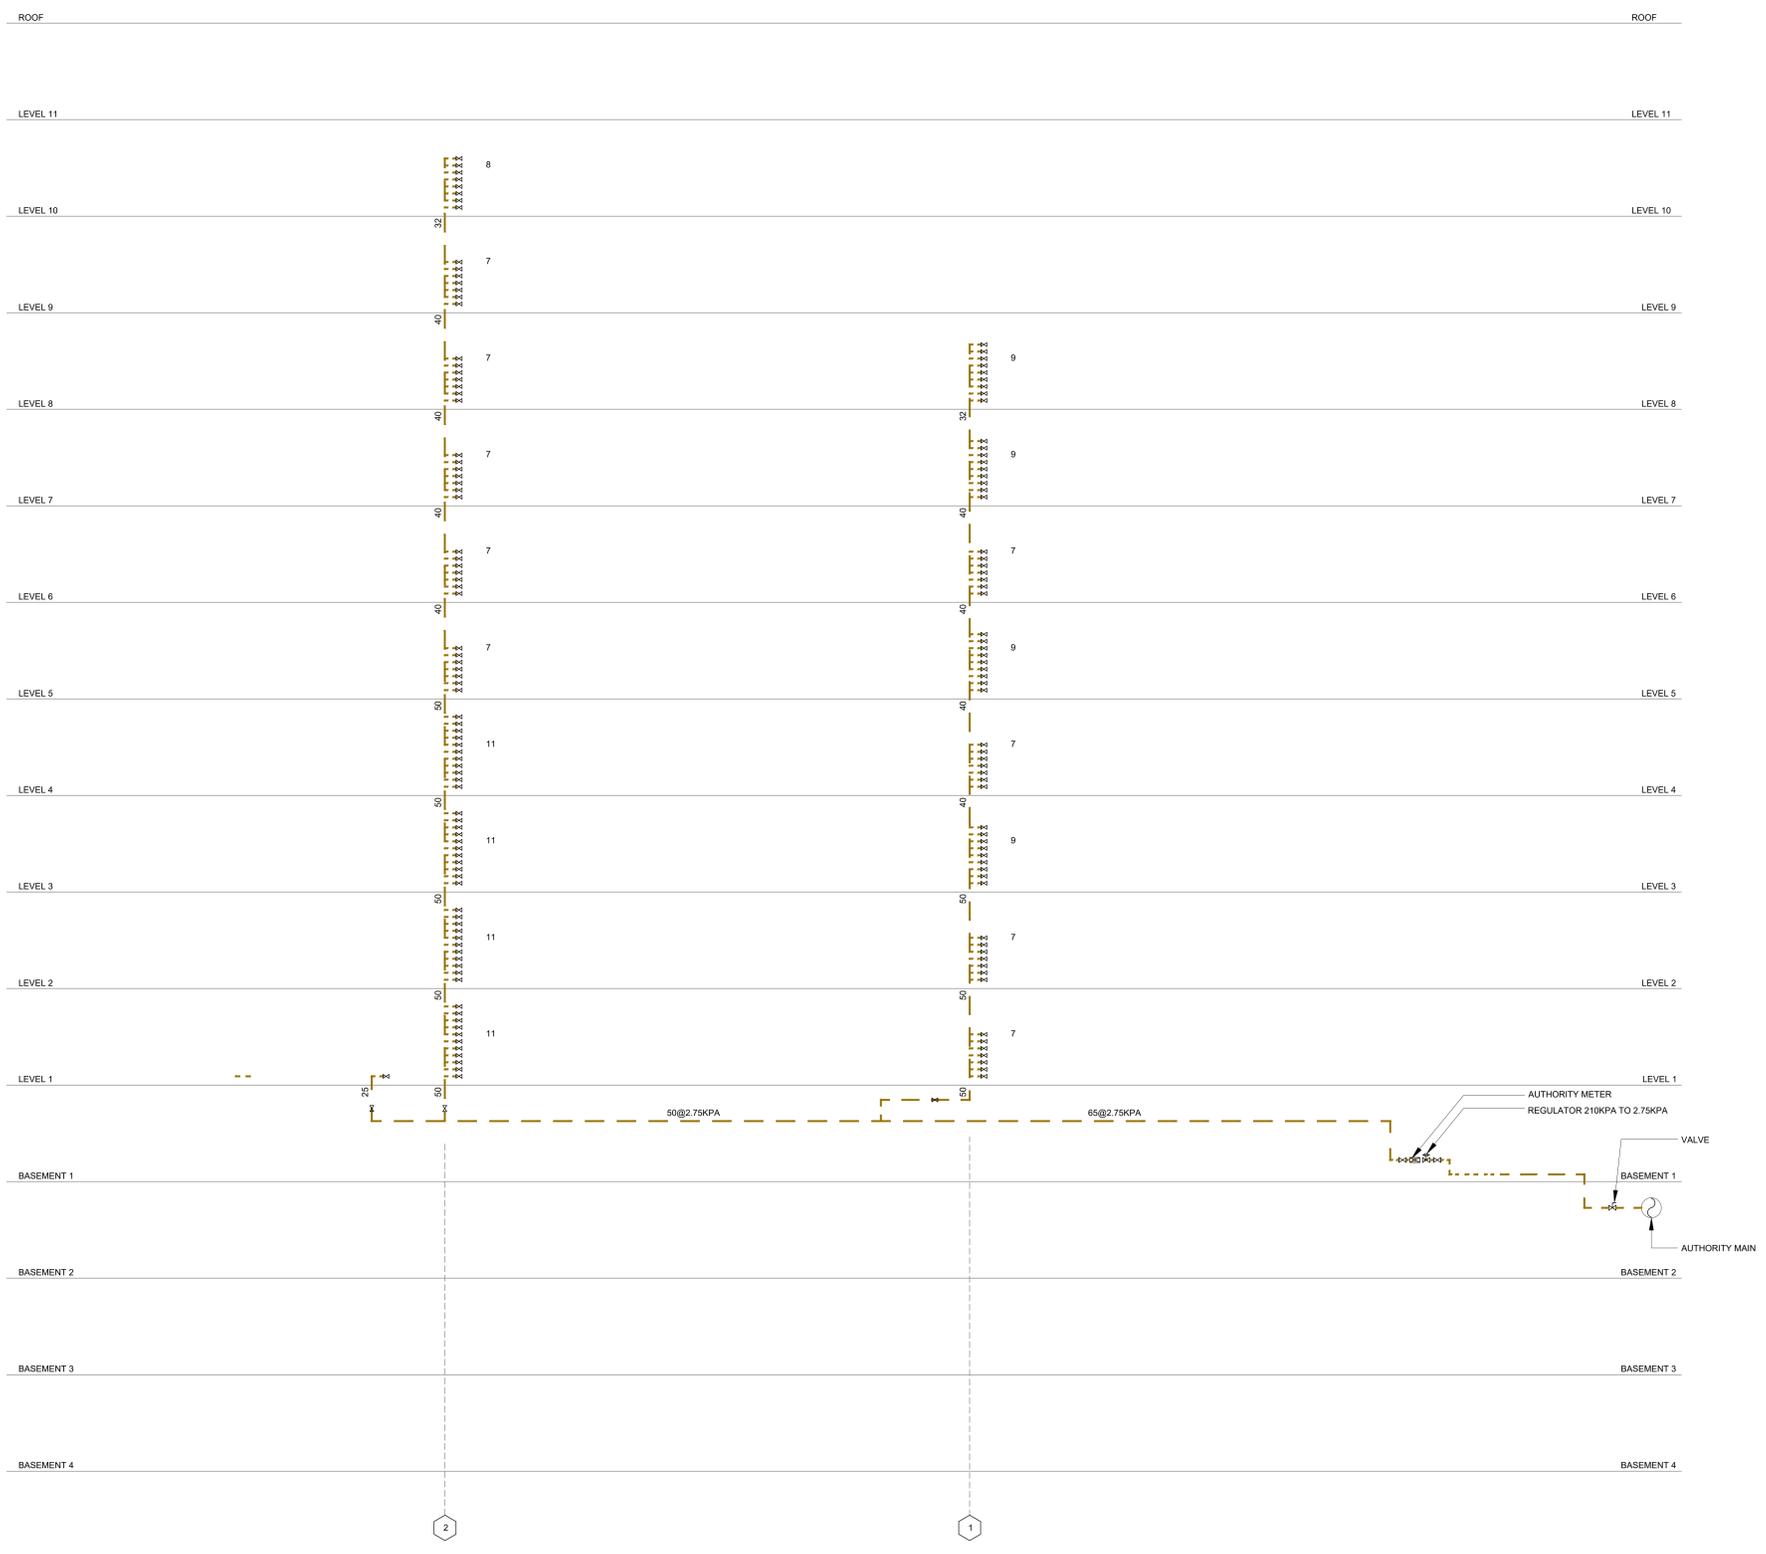

AS BUILT

NOTES		
COPYRIGHT OF ALION ENGINEERING GROUP. All rights reserved. This drawing may not be reproduced or transmitted in any form, or by any means in part or in whole without permission from ALION ENGINEERING GROUP. Figure dimensions shall be taken in preference to scaling. The contractor shall check all dimensions on drawings and site before commencing work.		
REVISION	ARCHITECT / PROJECT MANAGER	DATE
AS BUILT		20/01/19
ISSUE	AMENDMENT	DATE

CLIENT
<b>HOLDMARK</b> 2, 2-4 Giffnock Ave Macquarie Park NSW 2113 T: 02 9889 5540 info@holdmark.com.au

HYDRAULIC & FIRE SERVICES CONSULTANTS
<b>ALION ENGINEERING GROUP</b> PO BOX 8013 PORT MACQUARIE NSW 2444 T: 0403 852 312 Email: alan.thomas.aeg@gmail.com ABN2878949310

LOCATION PLAN
<b>KWIKFLO</b> group.com.au TRUE NORTH

PROJECT
SHEPHERDS BAY STAGE 8 20 - 36 NANCARROW AVE MEADOWBANK N.S.W 2144

PROJECT No.	DATE	DRAWN	No IN SET	SCALE
AEG104	25/05/2012	AT		NTS @ A0

DRAWING TITLE	DRAWING No.	REVISION
HYDRAULIC SERVICES NATURAL GAS SCHEMATIC	AEG-H40	AB