


REFERENCE DRAWINGS			
STRUCT			
MECH			
ELEC			
MEP			
ARCH			
DISCIPLINE	DRAWING NUMBER	REV	DATE

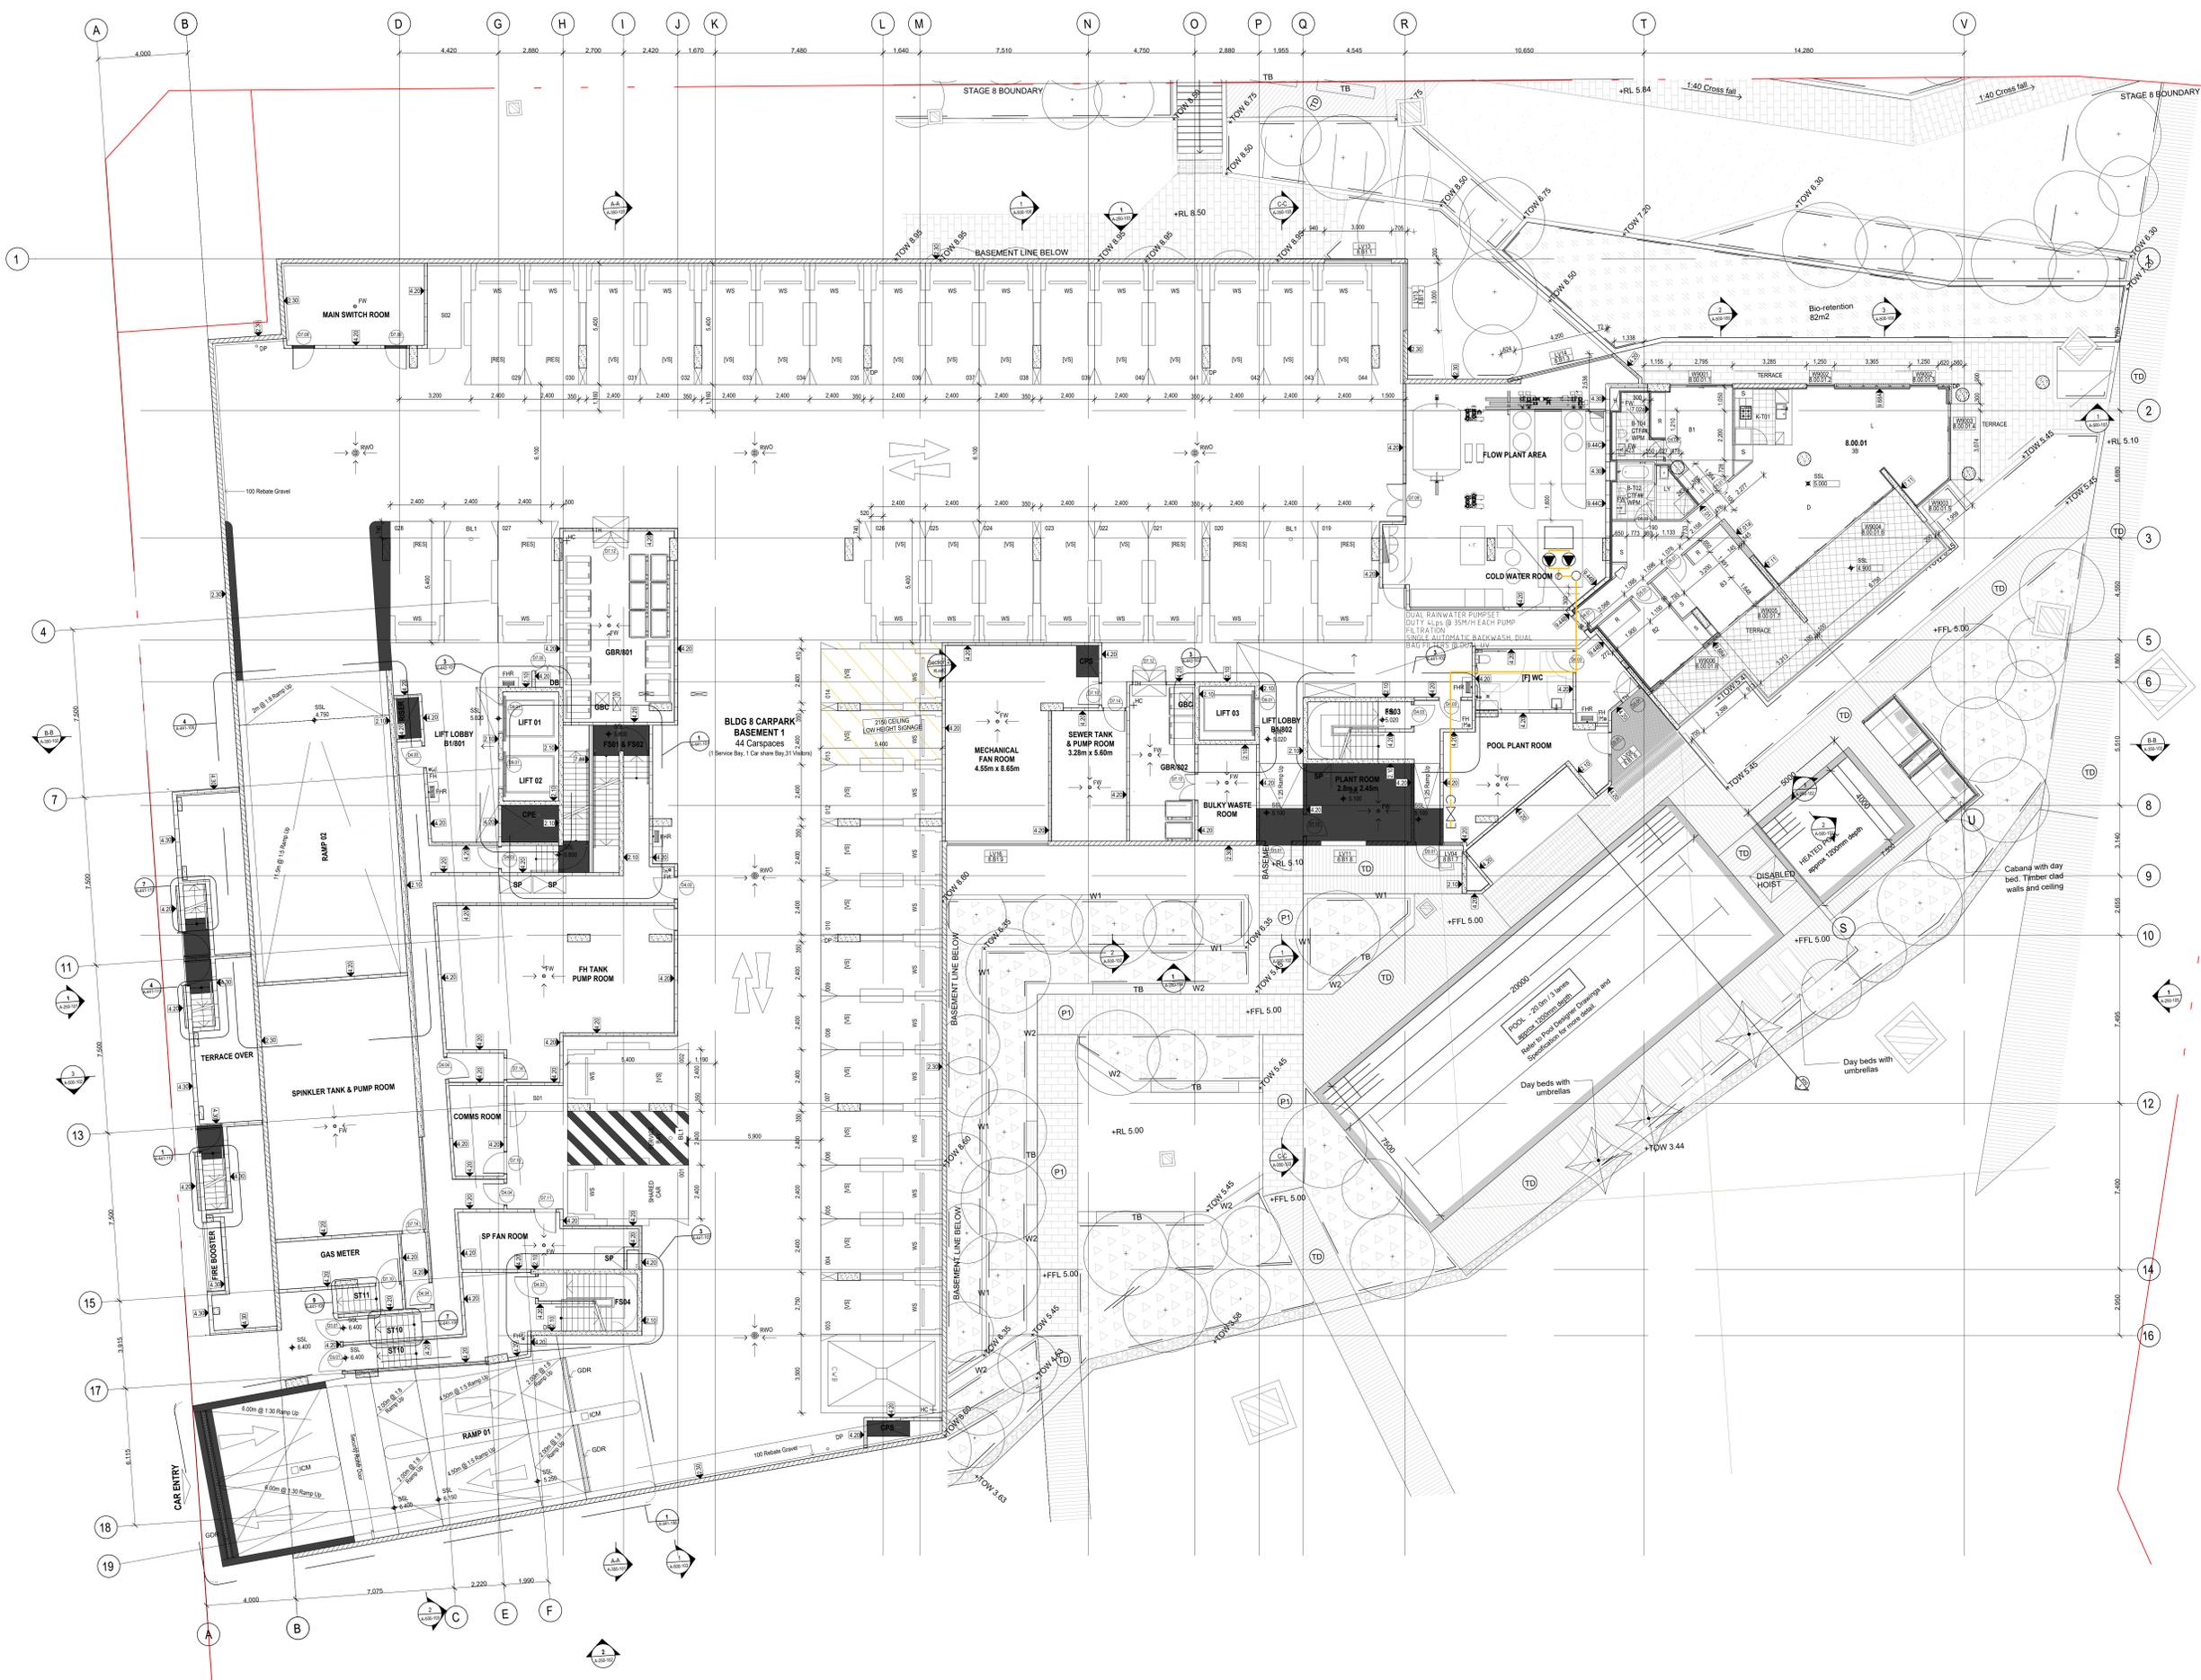

AS BUILT

NOTES

1. COPYRIGHT OF ALION ENGINEERING GROUP. All rights reserved. This drawing may not be reproduced or transmitted in any form, or by any means in part or in whole without permission from ALION ENGINEERING GROUP. Figure dimensions shall be taken in preference to scaling. The contractor shall check all dimensions on drawings and site before commencing work.

REVISION	ARCHITECT / PROJECT MANAGER	CLIENT
AS BUILT		
AMENDMENT		

DATE
30/11/18

**HOLDMARK**  
 2, 2-4 Giffnock Ave Macquarie Park  
 NSW 2113  
 T 02 9889 5540  
 info@holdmark.com.au

HYDRAULIC & FIRE SERVICES CONSULTANTS

**ALION ENGINEERING GROUP**

PO BOX 8013  
 PORT MACQUARIE  
 NSW 2444  
 T: 0403 852 312

Email: alan.thomas.aeg@gmail.com ABN2878949310

LOCATION PLAN

**KWIKFLO**  
 group.com.au

TRUE NORTH

PROJECT SHEPHERDS BAY  
 STAGE 8  
 NANCARROW AVE  
 MEADOWBANK N.S.W 2144

PROJECT No. AEG105 DATE 18/09/2017 DRAWN AT SCALE 1 TO 100 @ A0

DRAWING TITLE  
**HYDRAULIC SERVICES  
 BASEMENT 1  
 RW PRESSURE SERVICES**

DRAWING No. AEG-H05.2 REVISION AB