


REFERENCE DRAWINGS			
STRUCT			
MECH			
ELEC			
RFI			
ARCH			
DISCIPLINE	DRAWING NUMBER	REV	DATE

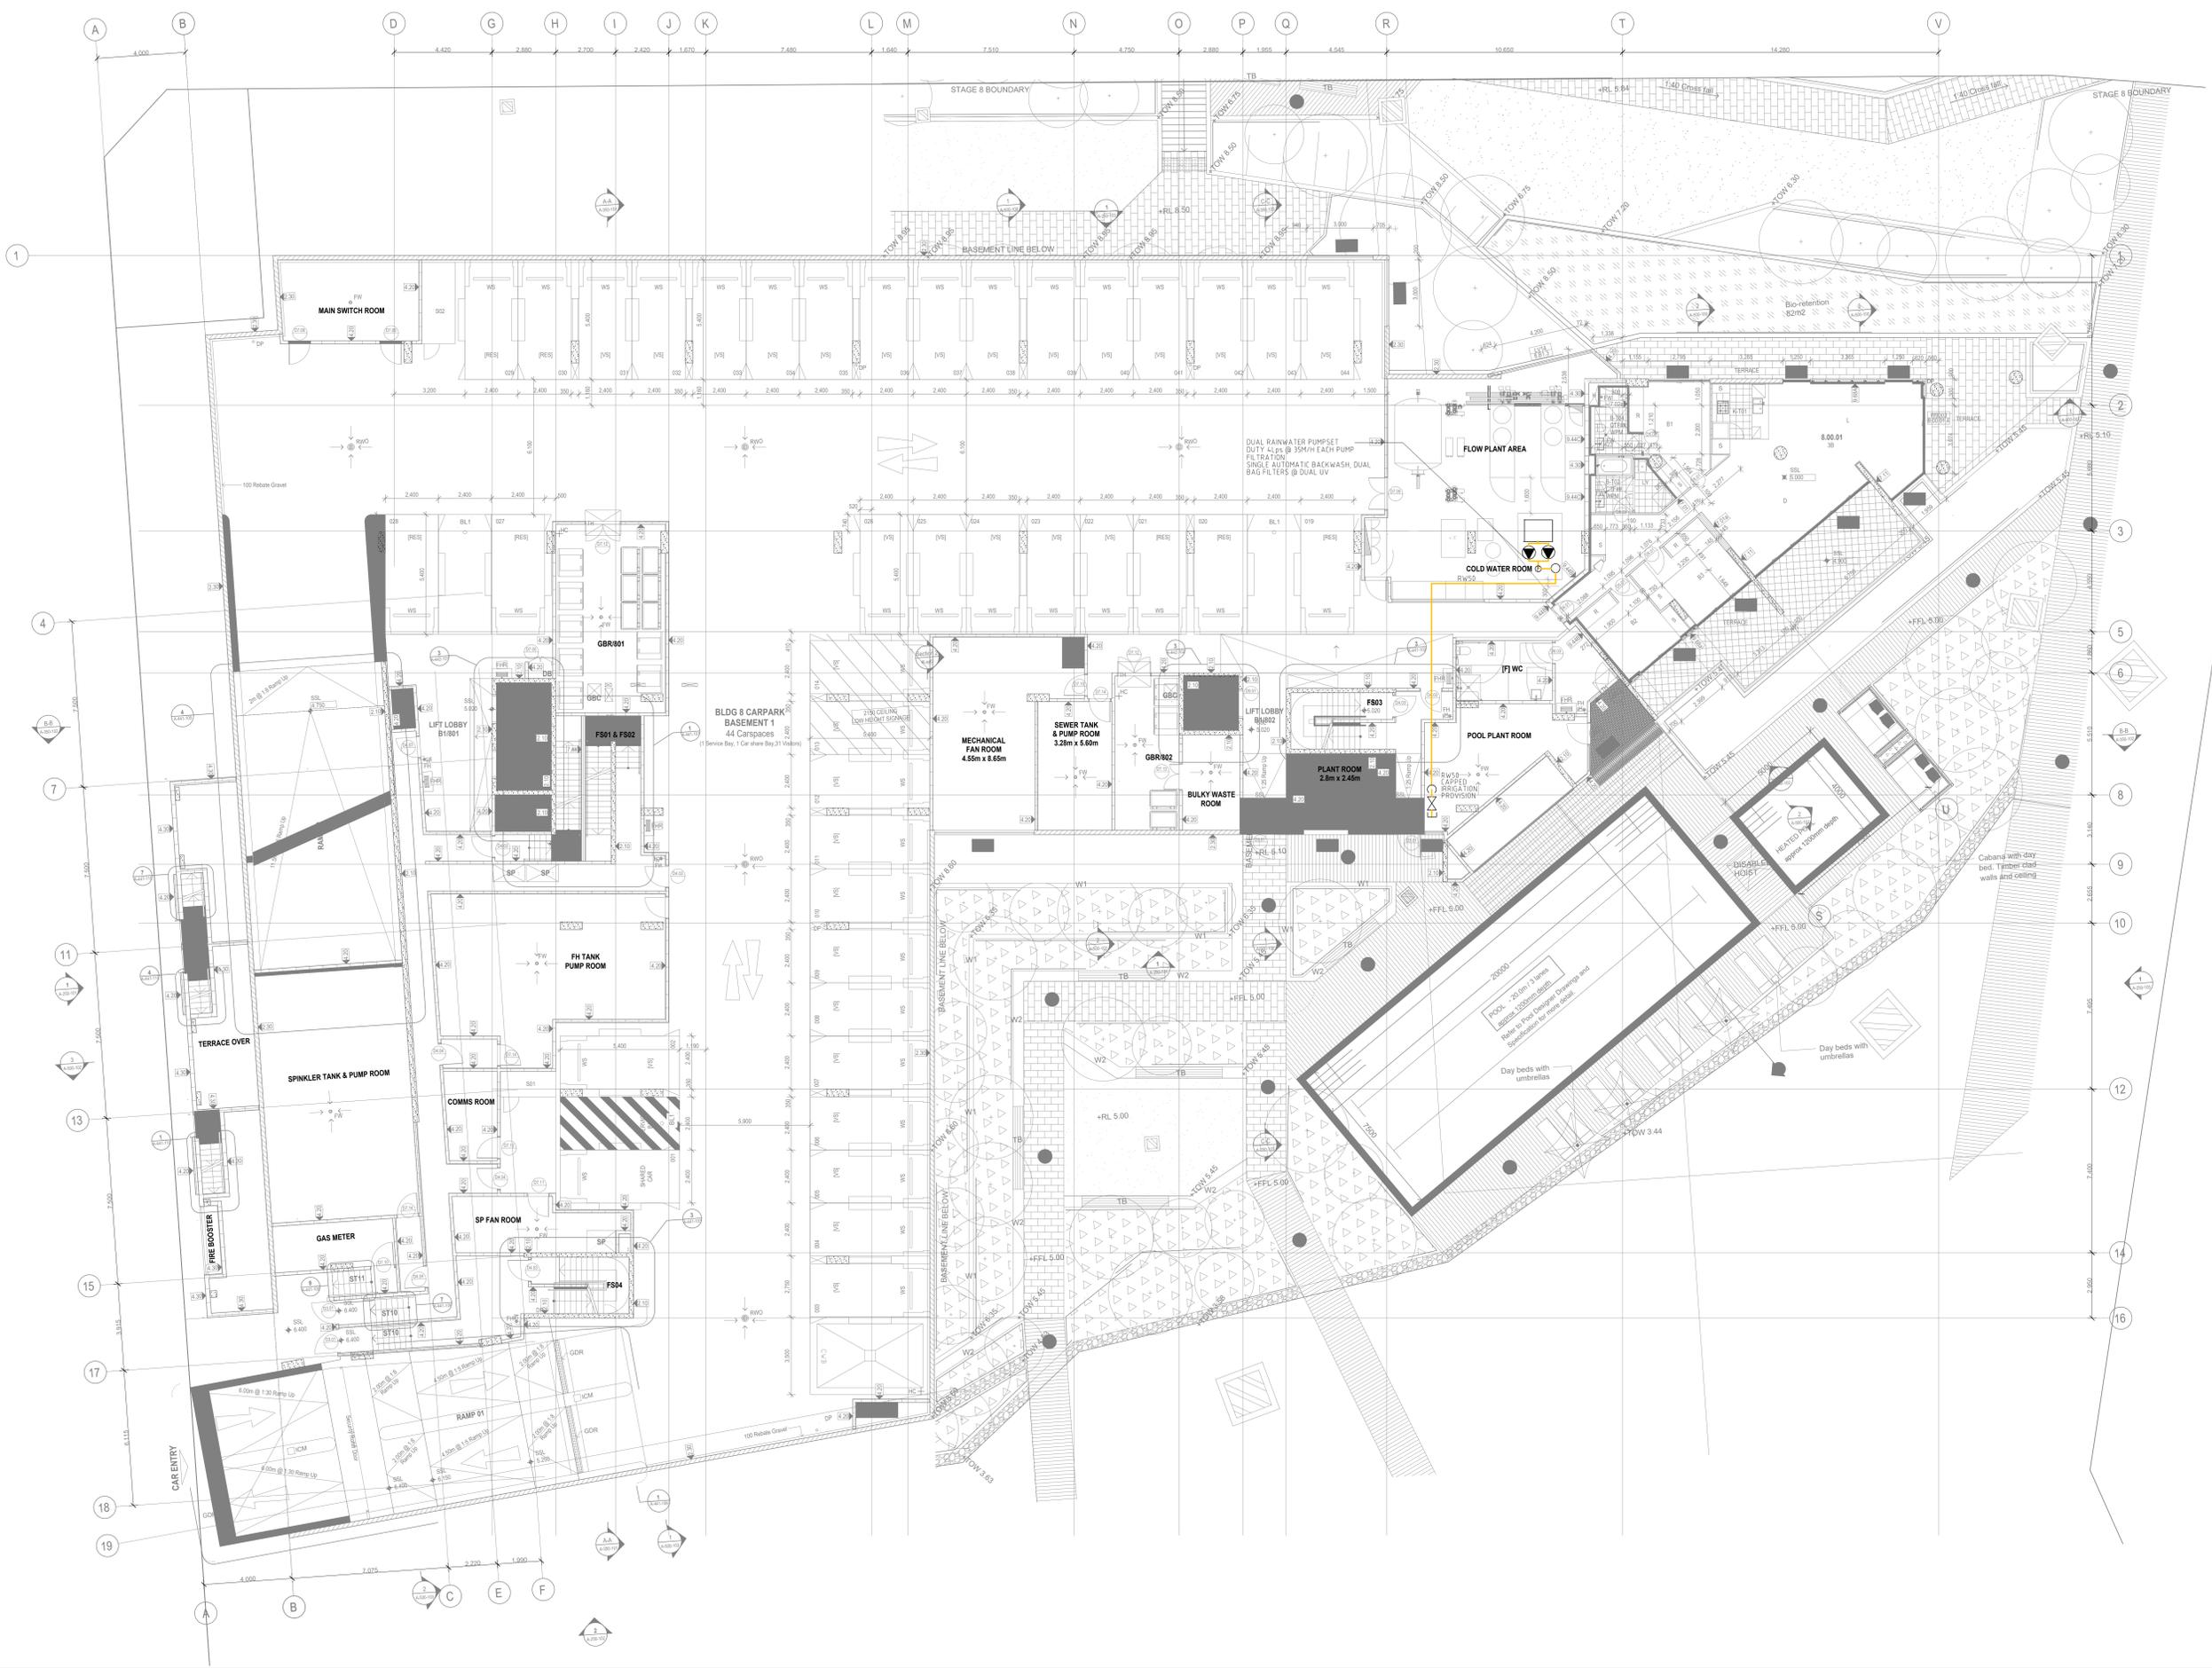

AS BUILT

NOTES

COPYRIGHT OF ALIGN ENGINEERING GROUP. All rights reserved. This drawing may not be reproduced or transmitted in any form, or by any means in part or in whole without permission from ALIGN ENGINEERING GROUP. Figure dimensions shall be taken in preference to scaling. The contractor shall check all dimensions on drawings and site before commencing work.

REVISION	ARCHITECT / PROJECT MANAGER	CLIENT
AS BUILT		
AMENDMENT		

REVISION	ARCHITECT / PROJECT MANAGER	CLIENT
AS BUILT		
AMENDMENT		

REVISION	ARCHITECT / PROJECT MANAGER	CLIENT
AS BUILT		
AMENDMENT		

HOLDMARK
 2, 2-4 Giffnock Ave Macquarie Park
 NSW 2113
 T 02 9889 5540
 info@holdmark.com.au

HYDRAULIC & FIRE SERVICES CONSULTANTS

ALIGN ENGINEERING GROUP

PO BOX 8013
 PORT MACQUARIE
 NSW 2444
 T: 0403 852 312

Email: alan.thomas.aeg@gmail.com ABN2878949310

LOCATION PLAN

KWIKFLO
 group.com.au

TRUE NORTH

PROJECT SHEPHERDS BAY
 STAGE 8
 NANCARROW AVE
 MEADOWBANK N.S.W 2144

PROJECT No. AEG105 DATE 18/09/2017 DRAWN AT SCALE 1 TO 100 @ A0

DRAWING TITLE
**HYDRAULIC SERVICES
 BASEMENT 1
 RW PRESSURE SERVICES**

DRAWING No. AEG-H22.1 REVISION AB